


Section through footpath  
scale 1:25

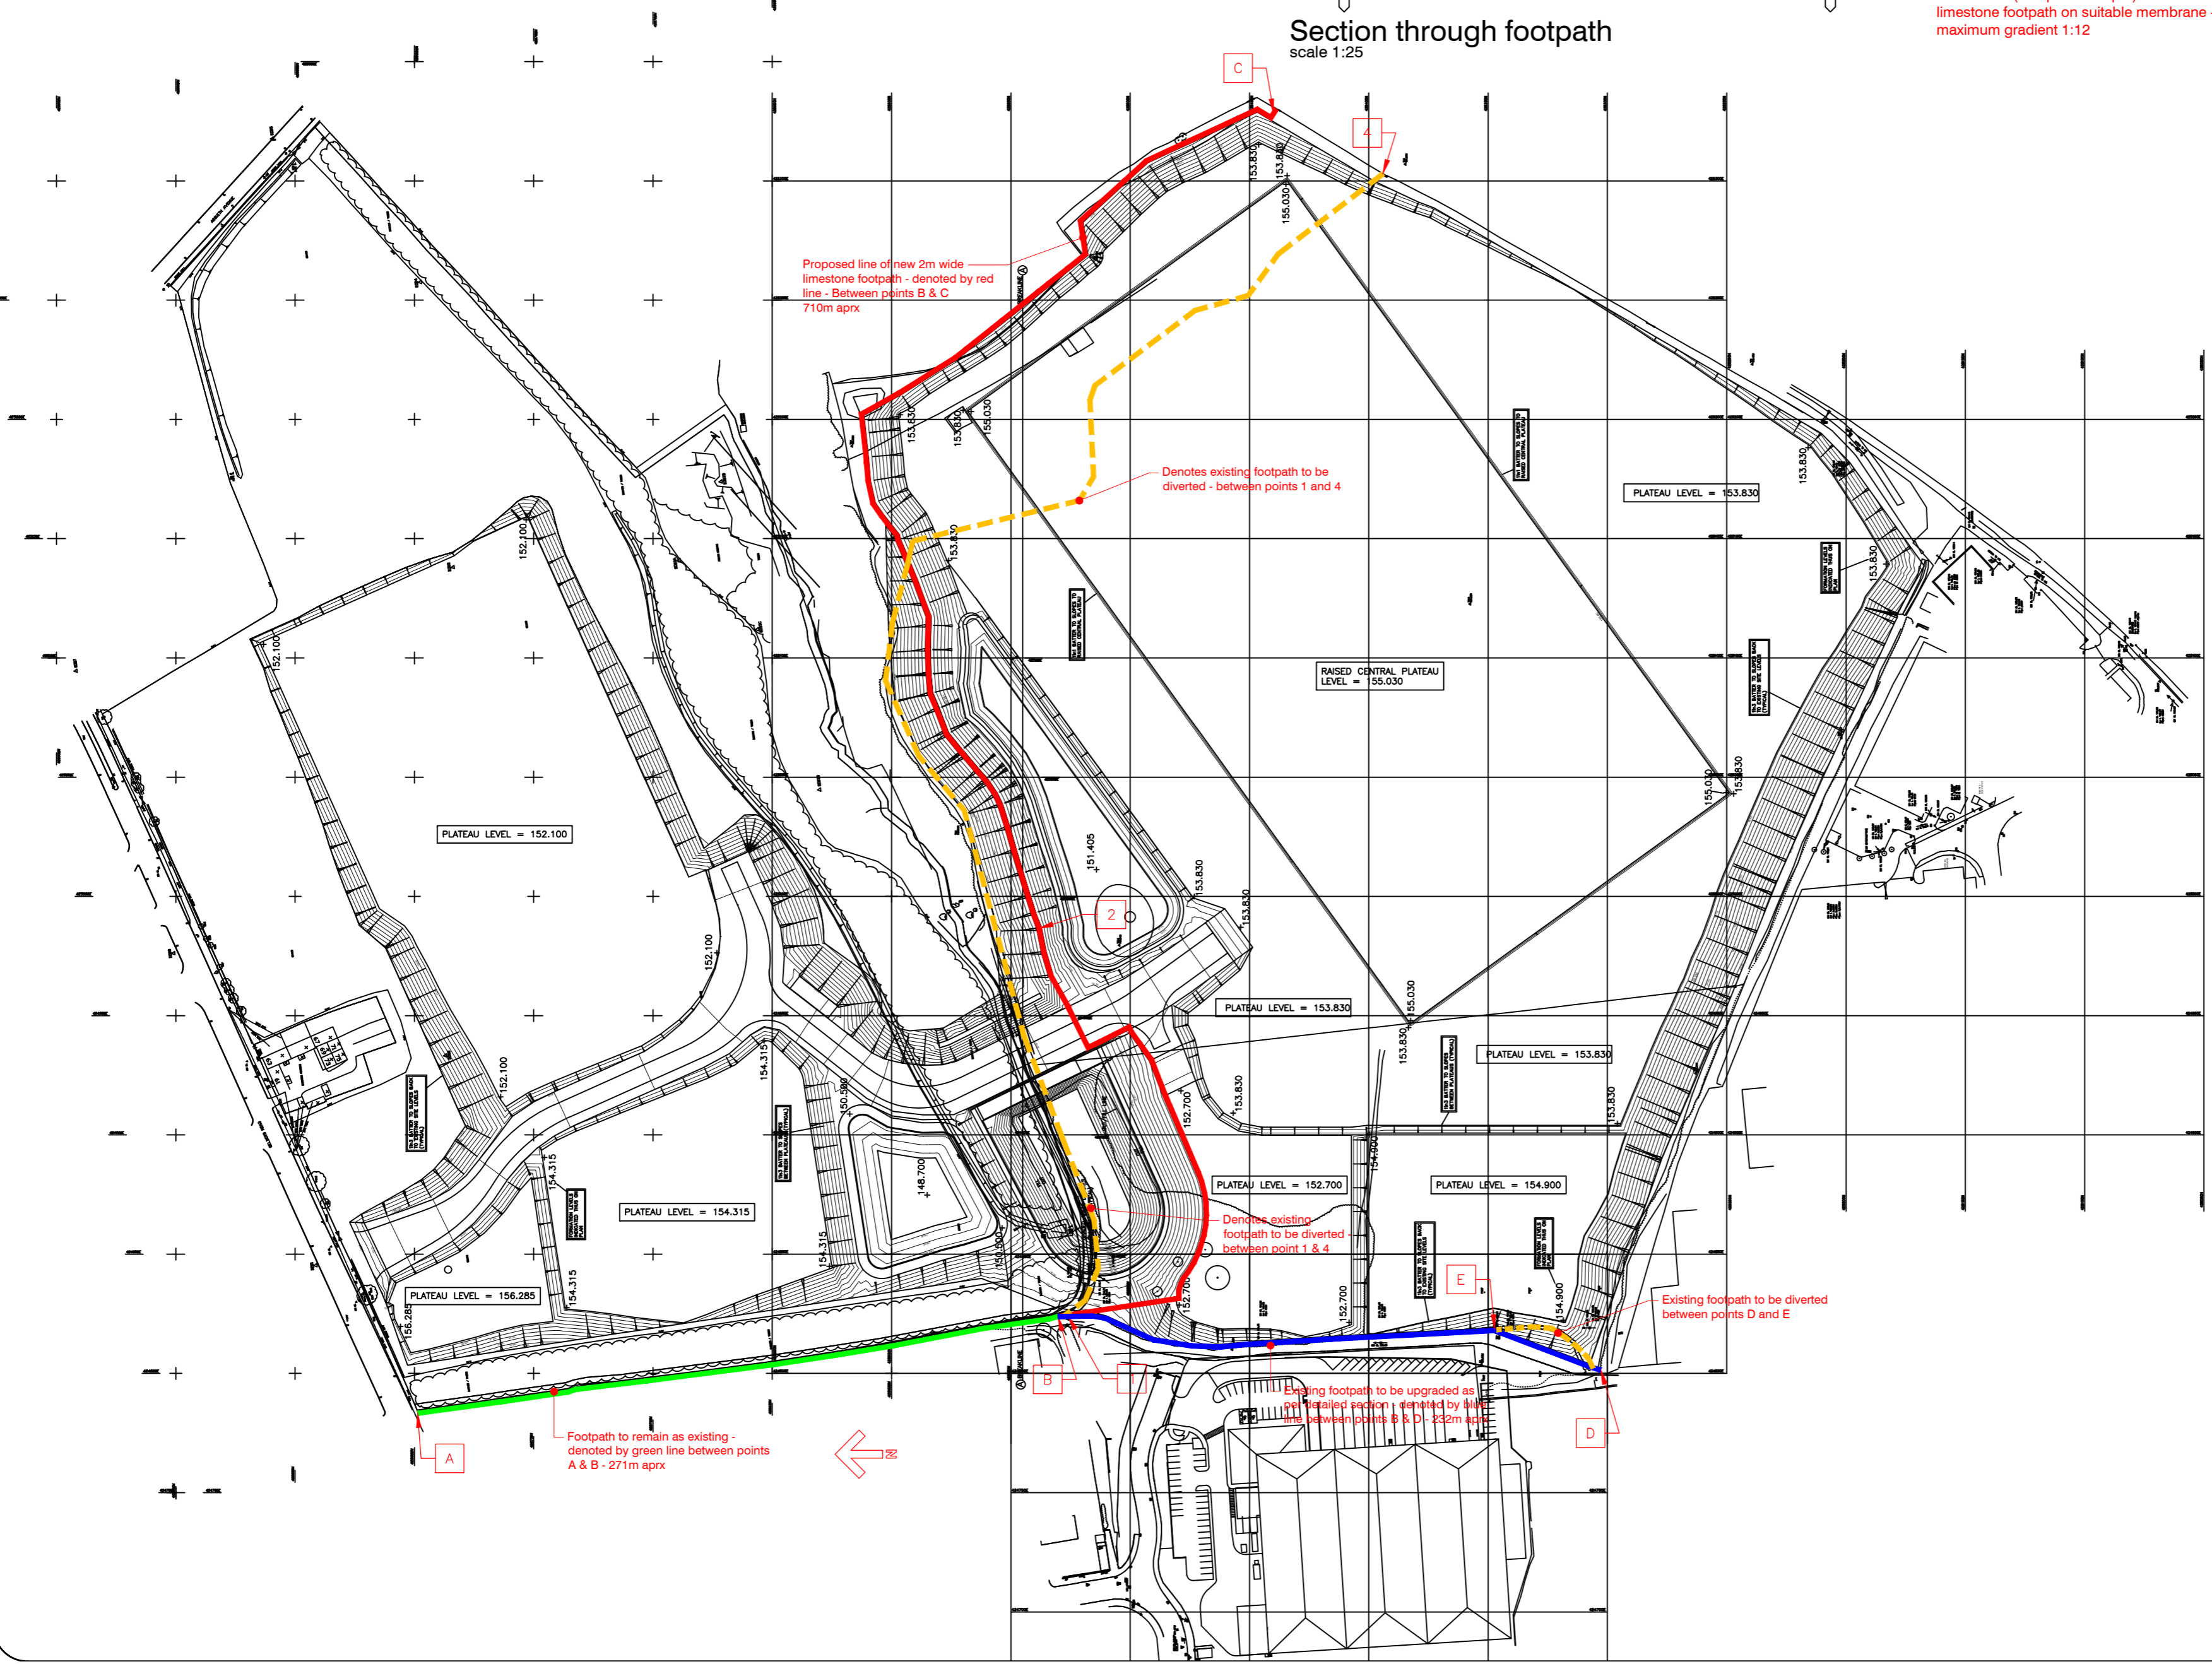

Proposed line of new 2m wide limestone footpath - denoted by red line - Between points B & C  
710m aprx

Denotes existing footpath to be diverted - between points 1 & 4

Footpath to remain as existing - denoted by green line between points A & B - 271m aprx

Denotes existing footpath to be diverted between point 1 & 4

Existing footpath to be diverted between points D and E

Existing footpath to be upgraded as detailed in section 1 denoted by blue line between points B & D - 322m aprx

COPYRIGHT RESERVED

Notes

Revisions

Rev	Date	Description
Rev.A	Apr 17	Sections of diverted existing footpath added
Rev.B	Apr 17	Drawing updated, section between points B and D added.
Rev.C	May 17	Drawing updated to match definitive existing routes.

BUILDING MANAGEMENT SERVICES LTD

Huddersfield Road  
Elland, West Yorkshire  
HX5 9BW  
TELEPHONE : ELLAND (01422) 371616  
FAX No : (01422) 376717  
email : mail@bmselland.com

# Building Management Services

Client



Commercial Development Projects Limited

Project

Proposed Industrial Park  
Off Geldred road  
Gildersome, Leeds

Sheet

Public Rights Of Way plan

Drawn ndj	Date mar 17
Scale 1@2000 @ A2	Status
Drawing No. M2711-13	Revision Rev.C.